

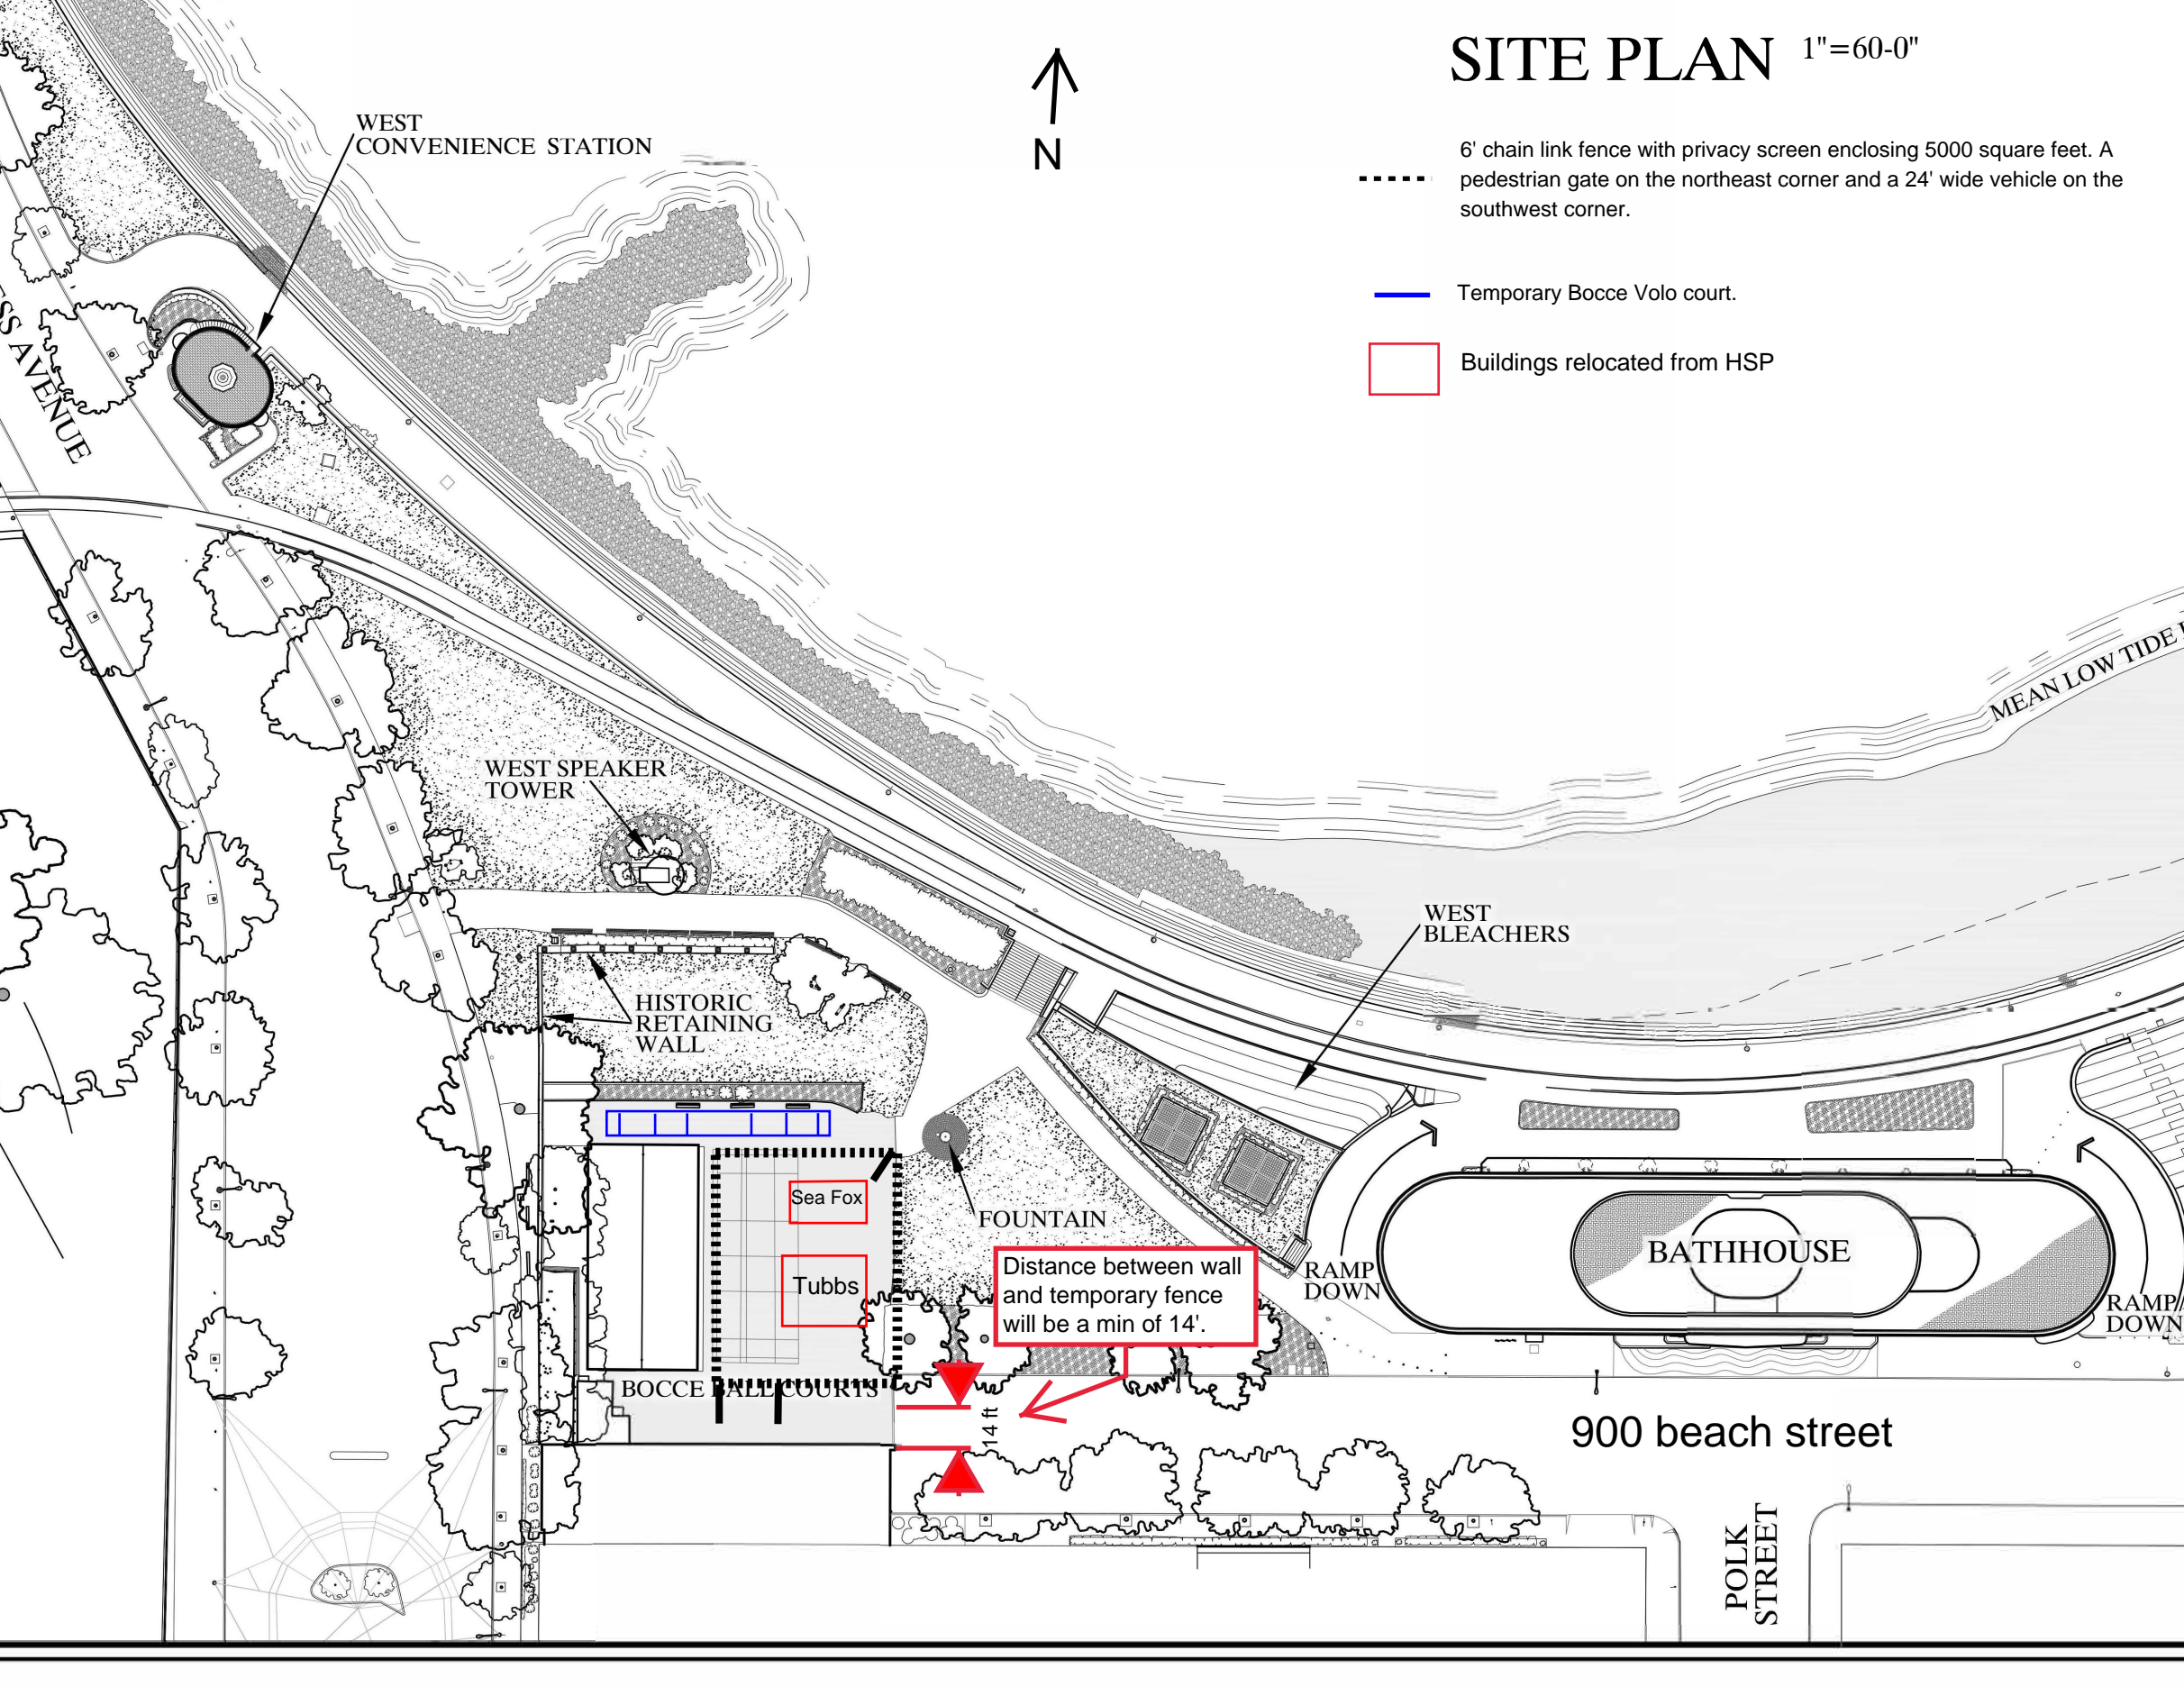
SITE PLAN 1"=60'-0"



----- 6' chain link fence with privacy screen enclosing 5000 square feet. A pedestrian gate on the northeast corner and a 24' wide vehicle on the southwest corner.

— Temporary Bocce Volo court.

□ Buildings relocated from HSP

 


 


# Tubbs and Sea Fox Move

The red line indicates the route of travel for buildings being relocated from Hyde Street Pier to the Bocce Ball Courts.

Legend

 2905 Hyde St

 Tubbs and Seafox Move

